

Message

From: Tate, Avilyn [Avilyn.Tate@sew.com.au]
Sent: 21/01/2025 9:51:50 AM
To: Swain, Charles [Charles.Swain@sew.com.au]
CC: Lloyd, Tim [Tim.Lloyd@sew.com.au]; Ramamurthy, Perna [Perna.Ramamurthy@sew.com.au]; Soens, Tye [Tye.Soens@sew.com.au]
Subject: McCrae Incident Water Sample

Flag: Follow up

Hello Charles,

Just letting you know that we had a customer calling about a leak at 12 Coburn Avenue, McCrae on 19/01/2025.

Dean Riley Personal Data - 12 Coburn Avenue, McCrae.

Noticed always water running in storm drains past year – like tap running on full.


Irrelevant & Sensitive

Irrelevant & Sensitive

As per tasks tracking register item 67, for those who report leaks outside of the previous sample locations to communicate with yourself for action to be taken by South East Water.

I have put an orange star at the new location.

Please let me know if you want us to log a job/task for this in Montage.

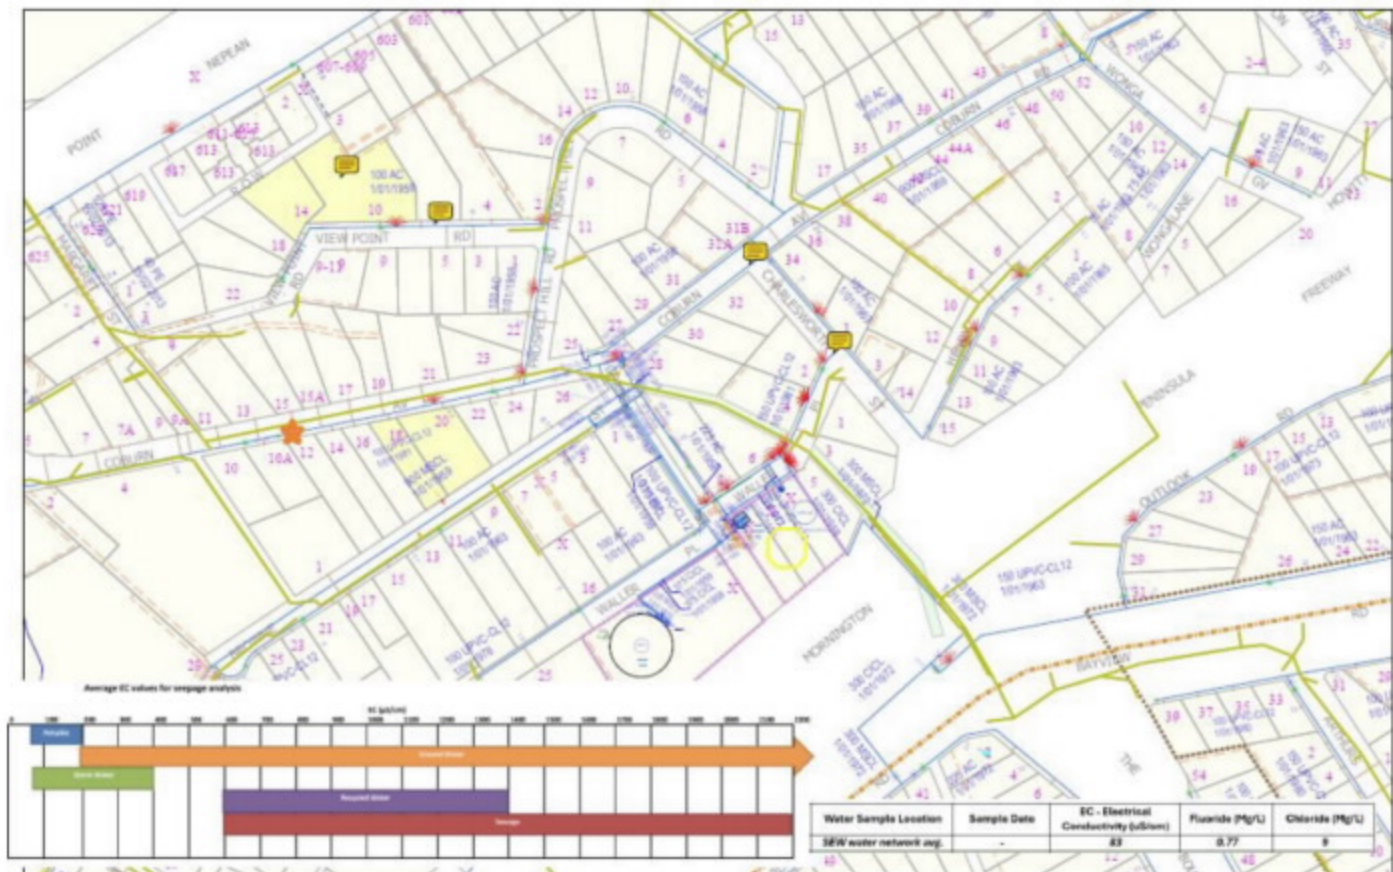

If there are any further questions, please let me know.

Kind Regards, Av
Avilyn Tate
Team Leader Faults and Emergencies



WatersEdge 101 Wells Street
Frankston VIC 3199

T +613 9552 3816

M

Personal Data



South East Water proudly acknowledges the Traditional Owners of the land on which we work and live, and pay respect to their Elders past, present and emerging. We acknowledge their songlines, cultural lore and continuing connection to the land and water. We recognise and value the rich cultural heritage and ongoing contributions of Aboriginal people and communities to our society in Victoria.